

BUILDING CODE INFORMATION

| | |
|-----------------------------|--|
| CLASSIFICATION OF WORK | EXISTING BUILDING CODE OF NEW YORK STATE ALTERATION - LEVEL 2 |
| USE DESCRIPTION | FILTER CONTROL BUILDING |
| OCCUPANCY USE | U - UTILITY & MISCELLANEOUS BUILDING IS UNOCCUPIED, ENTERED ONLY FOR MAINTENANCE |
| CONSTRUCTION CLASSIFICATION | TYPE IIB |
| NO. OF STORIES | ONE STORY |
| BUILDING HEIGHT | APPROX. 11'-0" |
| PROJECT AREA | 1060 SF |
| NO. OF ALLOWABLE OCCUPANTS | 11 |
| MAX. TRAVEL DISTANCE | 75 FT TO ONE EXIT |
| ACTUAL TRAVEL DISTANCE | 58 FT MAX. |

RECORD DRAWING

This drawing reflects changes from the original contract drawing that were made during construction and have been prepared from information provided to the Engineer by the construction contractor(s)/owner(s). The Engineer does not warrant this drawing to be complete and accurate in all respects.

MALCOLM PIRNIE, INC.


Date 2/17/12 By MAW

DOOR SCHEDULE


| DOOR TYPE | DOORS | | | | FRAME TYPE | LOUVER HT | JAMB DETAIL | REMARKS |
|-----------|-------|--------|-------|-------|------------|-----------|-------------|--|
| | WIDTH | HEIGHT | MAT'L | LABEL | | | | |
| A | 3'-0" | 8'-0" | FRP | - | F1 | - | 1 | HARDWARE GROUP 1; NEW DOOR & FRAME IN EXIST. OPENING |
| B | 3'-0" | 8'-0" | FRP | - | F1 | - | 2 | HARDWARE GROUP 1; NEW DOOR & FRAME IN EXIST. OPENING |

NOTE: FIELD VERIFY DIMENSIONS OF EXISTING MASONRY OPENINGS.

DOOR & FRAME TYPES

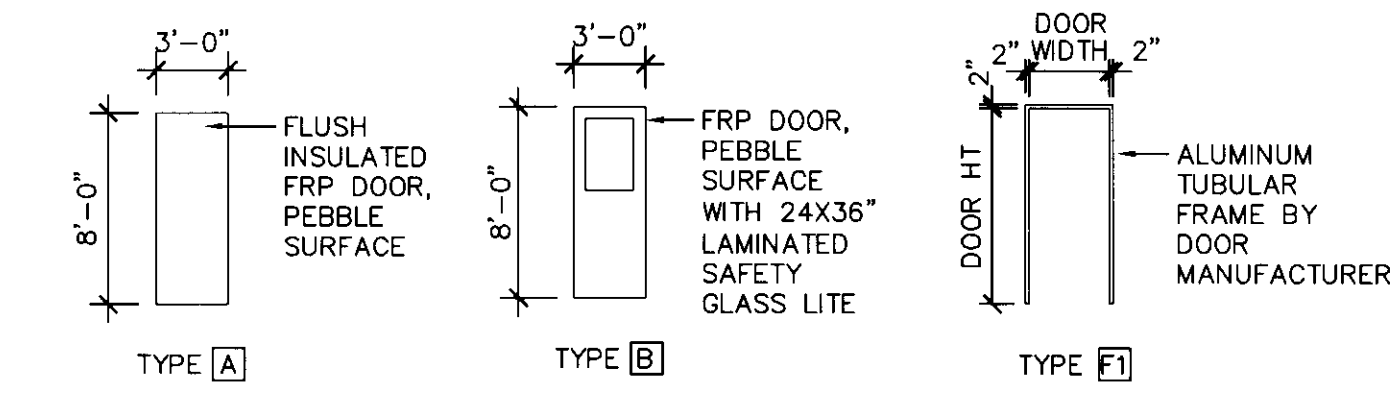

JAMB DETAILS

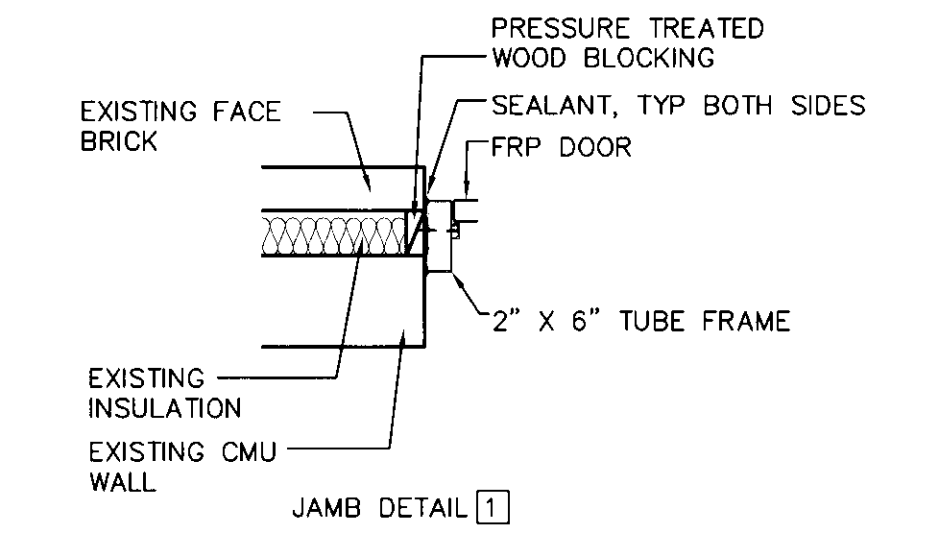

WARNING - IT IS A VIOLATION OF NEW YORK EDUCATION LAW, SECTION 7209.2, FOR ANY PERSON, UNLESS HE IS ACTING UNDER THE DIRECTION OF A LICENSED PROFESSIONAL ENGINEER OR LAND SURVEYOR, TO ALTER THIS DOCUMENT IN ANY WAY. IF ALTERED, THE ALTERING PERSON SHALL COMPLY WITH THE REQUIREMENTS OF NEW YORK LAW, SECTION 7209.2.



| NO. | | BY | DATE | REVISIONS | REMARKS |
|-----|-----|---------|-----------------|-----------|---------|
| 1 | MAW | 2/17/12 | RECORD DRAWINGS | | |

ONTARIO COUNTY, NEW YORK
HONEYE LAKE SEWER DISTRICT
FILTER BUILDING UPGRADES

ARCHITECTURAL FLOOR PLAN

1/4" = 1'-0"

COPYRIGHT © 2010 MALCOLM PIRNIE, INC.
DATE FEBRUARY 2010
A SHEET 1 OF 1
CAD REF. NO. A1